



Exhibit B - Schematic Illustration of Water Surface Conditions

"As Designed" Water Surface (Idealized):

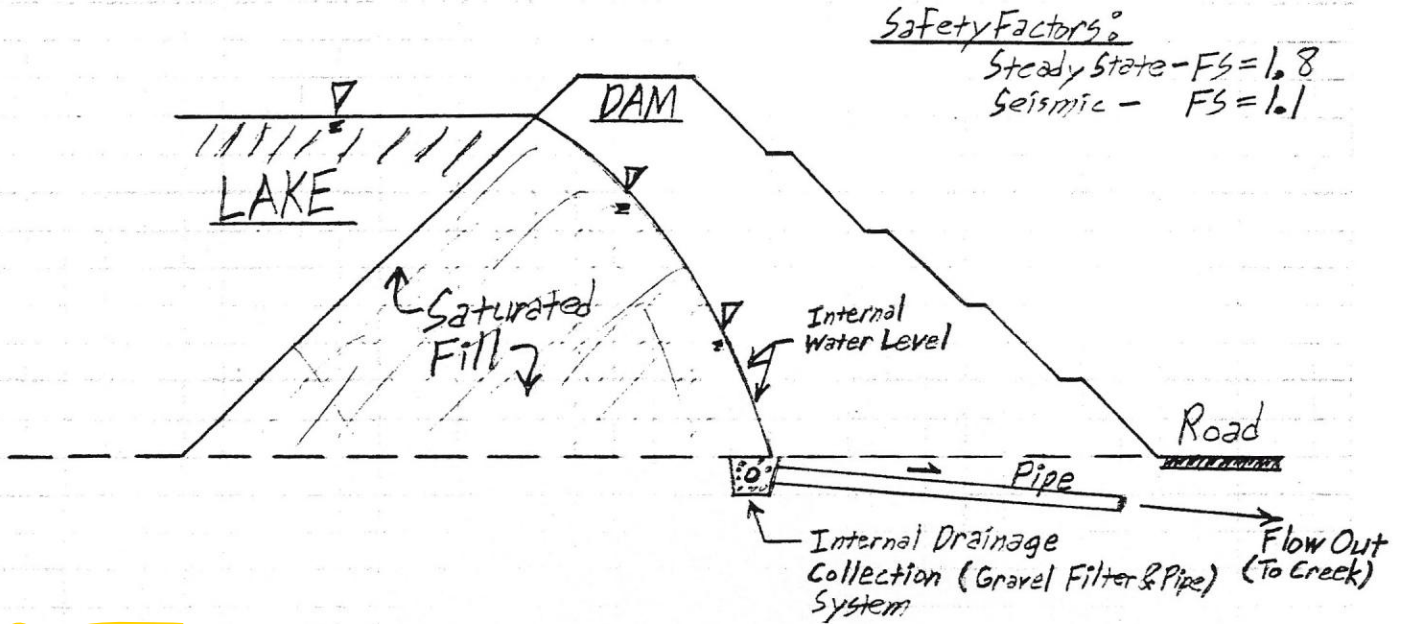

"As Built" Water Surface (Estimated):

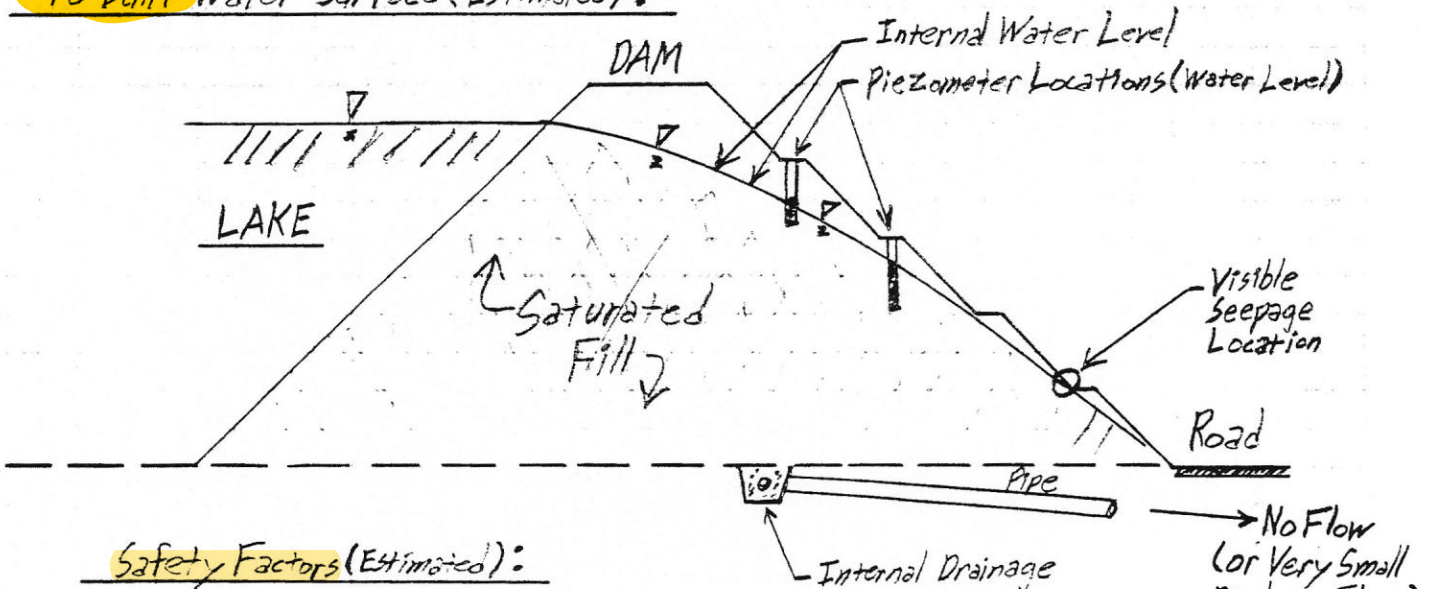

Safety Factors (Estimated):

Steady State  $\rightarrow FS = 1.1 < 1.5$   
 Seismic  $\rightarrow FS = 0.7 < 1.1$

Safe Dams' Minimum Criteria (1997)